
※ 인쇄 시 "실제 크기(100%)"로 설정해야 지정 축척이 성립합니다.

준 공 도 · 검토 요청 · 검증 2026-11-03

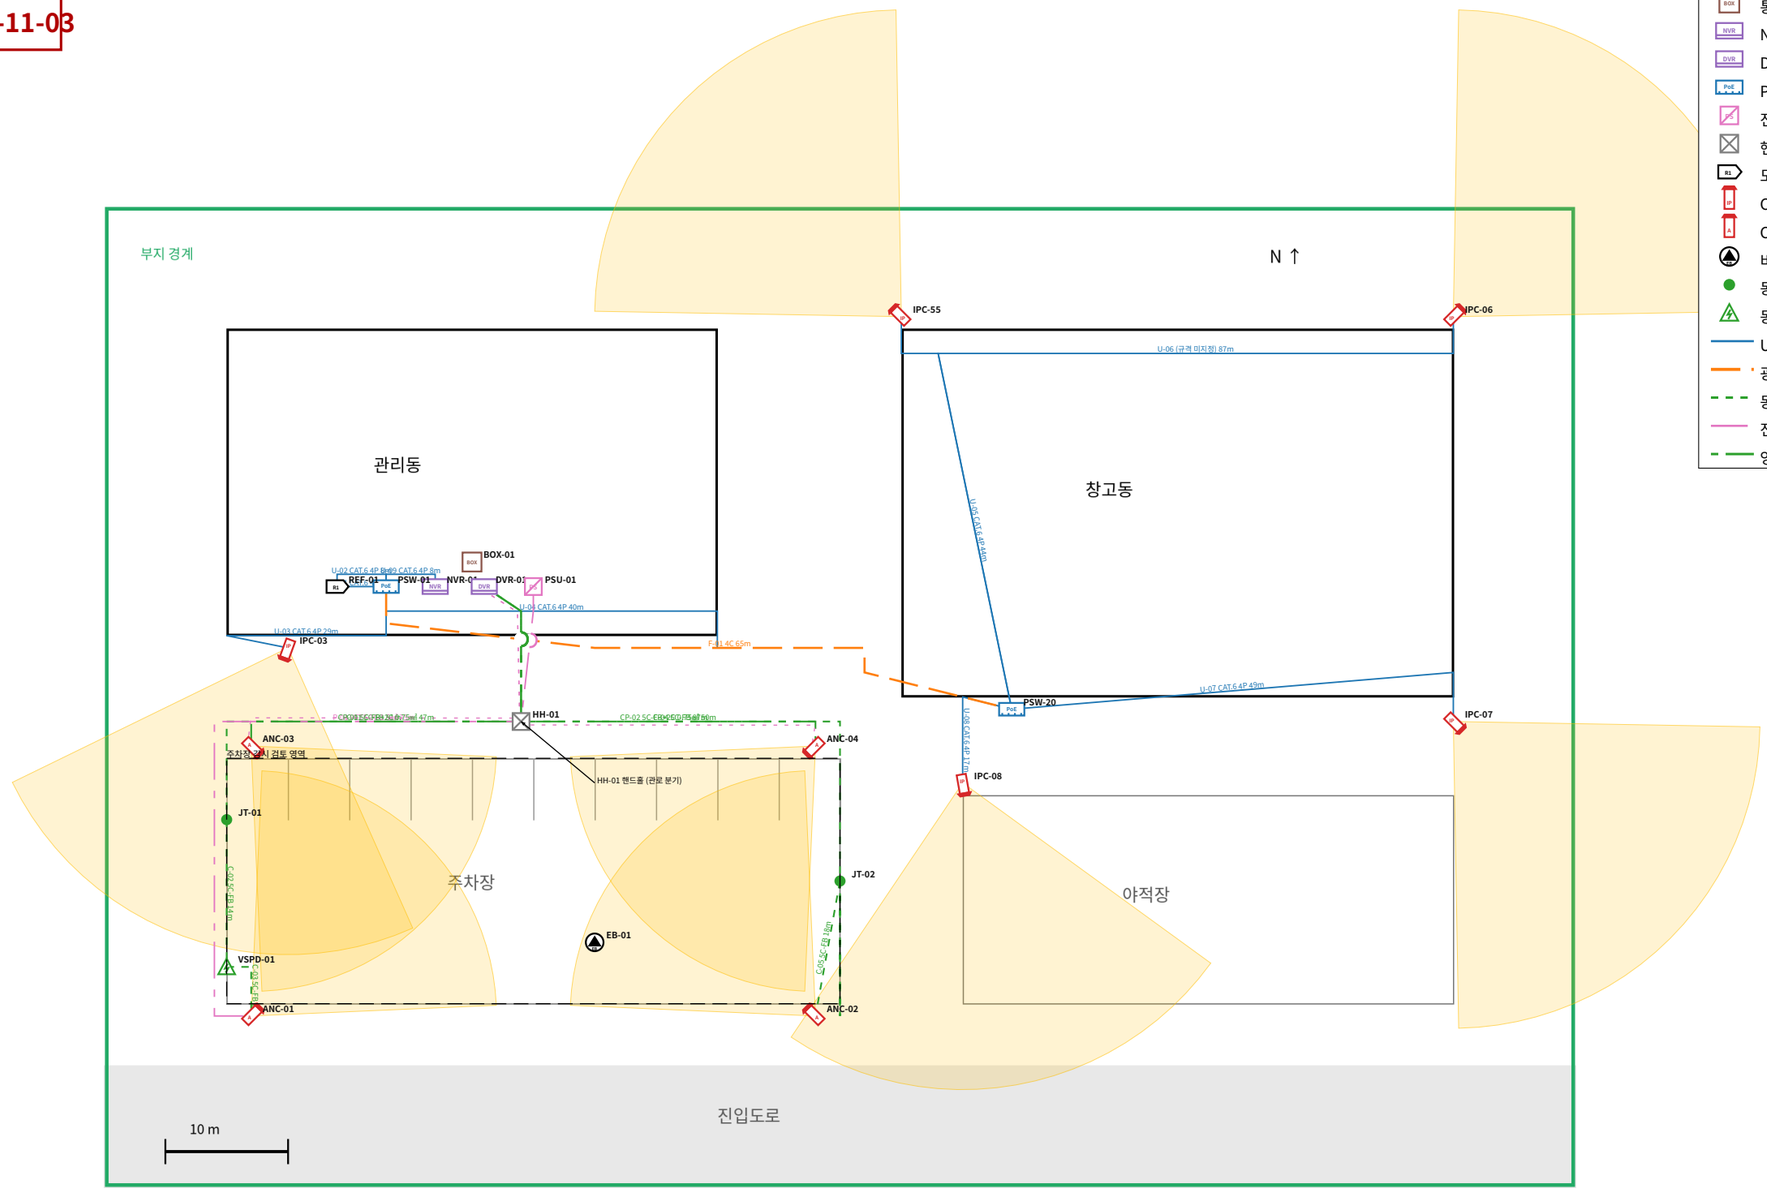

범 례

- 통신함체
- NVR
- DVR
- PoE 스위치
- 전원공급장치
- 핸드홀
- 도면 간 연결 참조
- CCTV (IP 불릿형)
- CCTV (동축 불릿형)
- 비상벨
- 동축 중간 접속점
- 동축 영상 서지보호기
- UTP (U-)
- 광케이블 (F-)
- 동축케이블 (C-)
- 전원케이블 (P-)
- 영상·전원 복합 (CP-)

0 — 25m 막대 축척

회사	공사명	도면명	도면번호	축척	작성일	개정	설계	검토	승인
에스에스전력	**[샘플] ○○물류센터 CCTV 설치공사 (복원 2026. 11. 3.)**	**현장 CCTV 배치도 - CCTV 배치도 (준공도)**	CCTV-001	1:500 (A3 실제 크기 인쇄 시)	2026-11-03	0	홍길동	김검토	